

Town of Washington Inland Wetlands Commission


APPLICATION TO MODIFY AN APPROVED PERMIT

1. Address of Permitted Activity: 23 Loomarwick Road, New Preston, CT
2. Name of Property Owner: LGA Holdings LLC Nancy Sarnoff Williams
3. Granted Permit # IW- 20-55 Approval Date: Oct. 28, 2020 Granted for: 2 years
4. Mailing Address of Property Owner:
9 Dewart Road, Greenwich, CT 06830
5. Property Owner's Phone Number: 203-940-2750 Email: nancysarnoffwilliams@me.com
6. Authorized Agent: _____ Letter of Authorization? Yes No
7. Agent's Phone Number: _____ Email: _____
8. Brief Discussion of Permitted Activity(s): Lakeside improvement plan/landscaping design plan


9. Per Section 8.08.b of the Inland Wetlands & Watercourses Regulations please provide on a separate sheet:
- a. reasons for and nature of all proposed revisions
 - b. assessment of the potential increase or diminished impact to the wetlands, watercourses, and/or to the regulated area due to the proposed revision
 - c. revised site plan or map
 - d. revised sequence of construction
 - e. revised erosion and sedimentation control plan (if applicable)
 - f. any other pertinent information

10. This application must be completed in its entirety, signed by the property owner and supporting documents: 1) Attached required information, 2) Yellow Mandatory Land Use Pre-Application Form signed by the property owner, written approval from the conservation easement holder, if applicable, 3) Agent Authorization Letter, if applicable, and 4) \$60 Fee – per Section 9.01 of the Inland Wetlands & Watercourses Regulations.

The undersigned property owner consents to necessary and proper inspections of the above mentioned property by the IWC and/or its agent at reasonable times, both before and after action on this application:

 Nancy Williams April 7, 2021
Signature of Property Owner (live ink) LGA Date

Office Use: Approved Permit: IW-20-55^M Fee: \$ 60 Check # 1755 Date: 4-20-21 Cash _____
Received by: S White Date: 4-20 Scanned
L:\Application Packets -- Scanned\Inland Wetland Forms\IWC to Modify Approved Permit 4.22-21

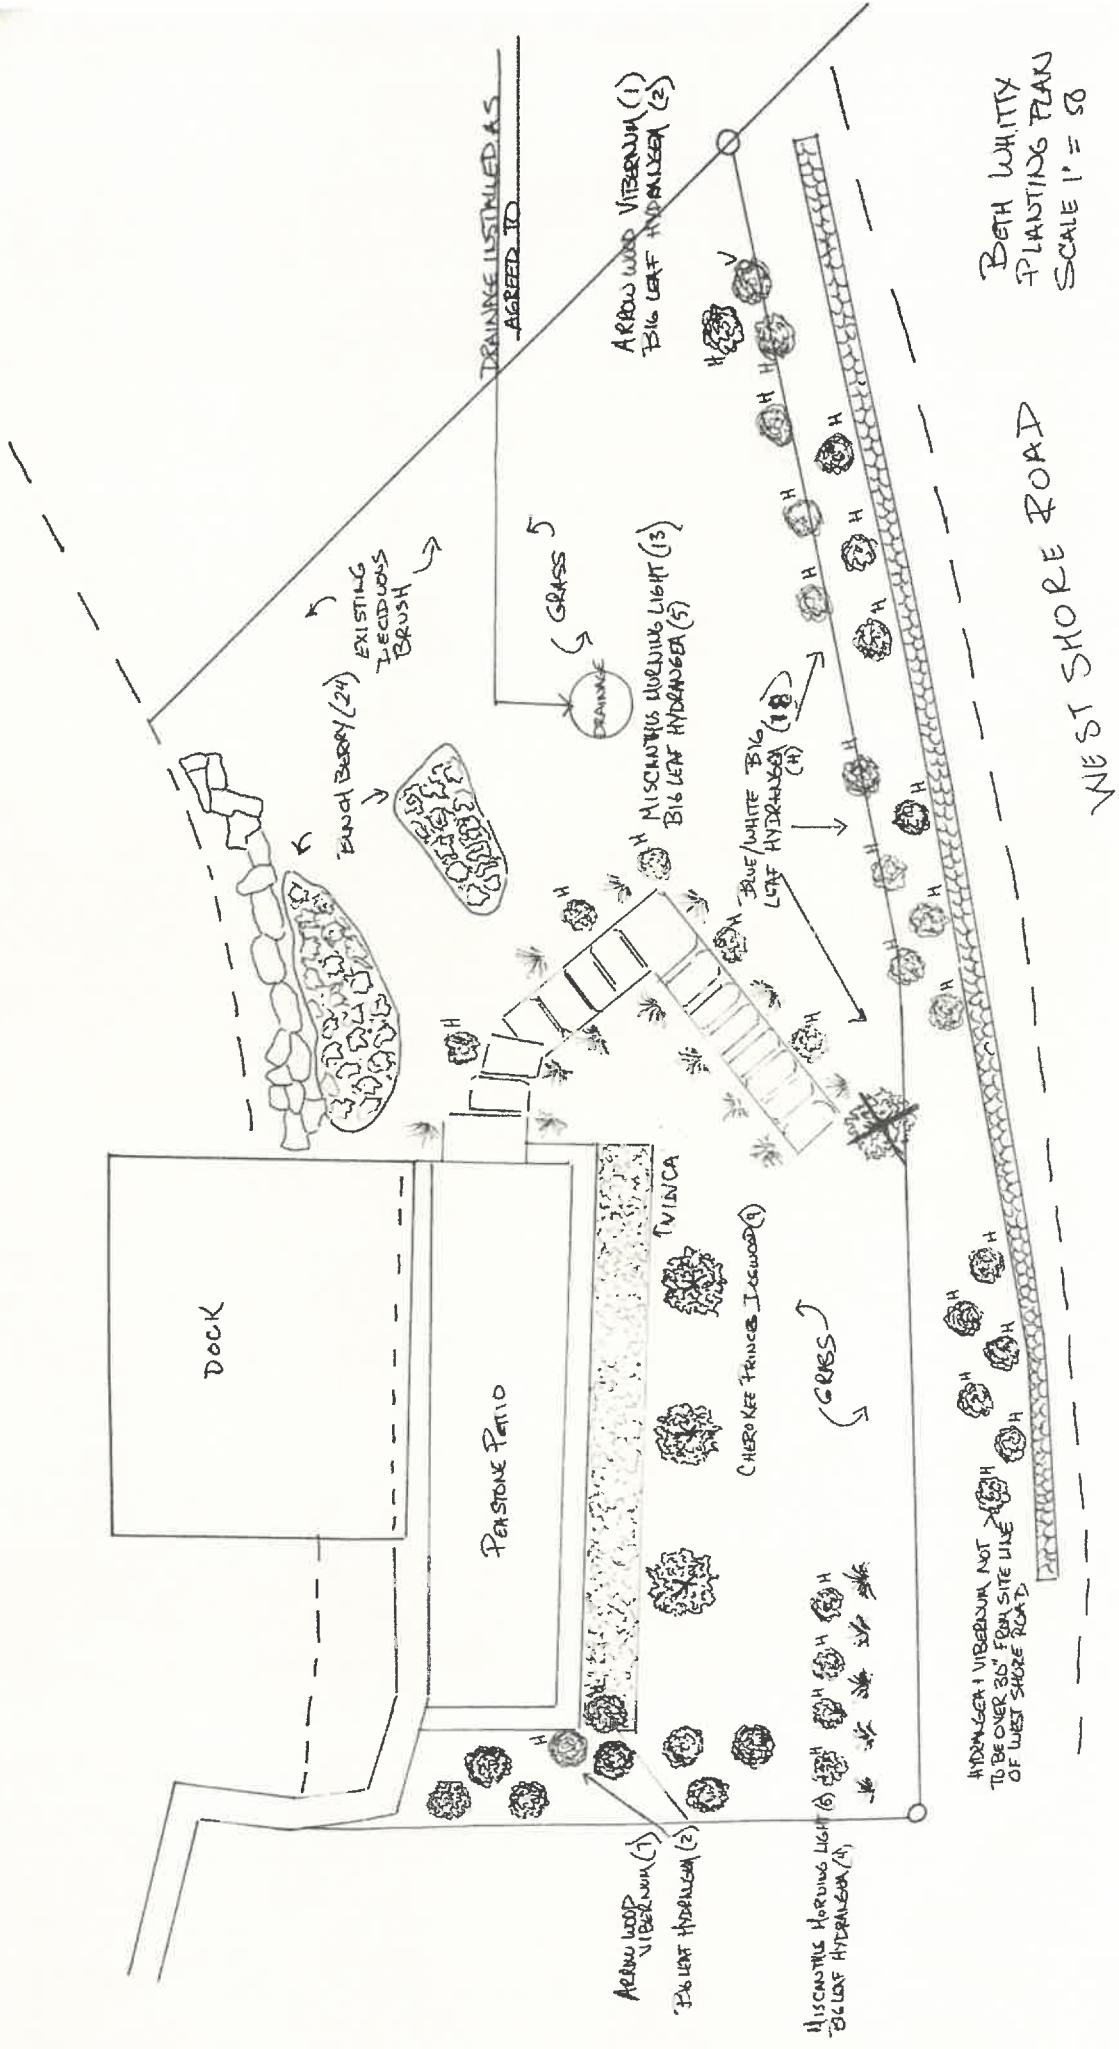

BETH WHITTY
 PLANTING PLAN
 SCALE 1" = 8'

WEST SHORE ROAD

DOCK

PERISTYLE PATIO

VINCA

CHEROKEE FRANCES JASMIN (4)

ARROW WOOD VIBERNUM (1)
 BIG LEAF HYDRANGEA (2)

MISCHANTHUS LUCIDUS LIGHT (13)
 BIG LEAF HYDRANGEA (4)

MISCHANTHUS LUCIDUS LIGHT (13)
 BIG LEAF HYDRANGEA (5)

BLUE/WHITE BIG LEAF HYDRANGEA (4)

ARROW WOOD VIBERNUM (1)
 BIG LEAF HYDRANGEA (2)

EXISTING DECIDUOUS BRUSH

BUNCH BERRY (24)

GRASS

DRAINAGE ILLUSTRATED AS AGREED TO

HYDRANGEA VIBERNUM NOT TO BE OVER 30" FROM SITE LINE OF WEST SHORE ROAD

